


SOUTH EASTERN RAILWAY, SAMBALPUR OPC ROUTE PLAN RAIPUR TO MANDIR HASAUD

RAIPUR

TITLAGARH

RSD	89
RSD	88
RSD	87
RSD	86
RSD	85
RSD	84
RSD	83
RSD	82
RSD	81
RSD	80
RSD	79
RSD	78
RSD	77
RSD	76
RSD	75
RSD	74
RSD	73
RSD	72
RSD	71
RSD	70
RSD	69
RSD	68
RSD	67

CENTRE OF THE TRACK

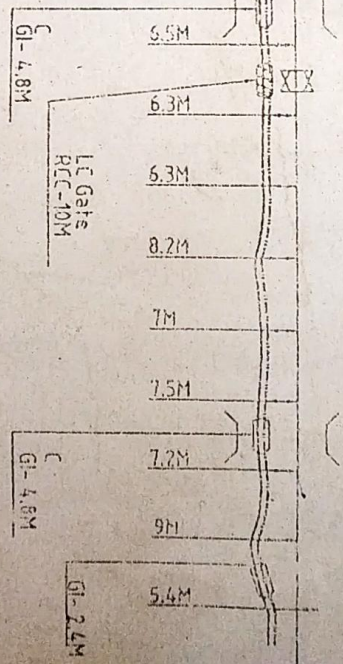

LEGEND

SYMBOL	DESCRIPTION	SYMBOL	DESCRIPTION	SYMBOL INDEX USED
OPC/DUCT SHOWN		(Symbol)	CULVERT	OS-ORDINARY SOIL
6 CORE SIG CABLE SHOWN		(Symbol)	GRIDER BRIDGE	RS-ROCKY SOIL
POWER CABLE		(Symbol)	LEVEL XING GATE	BR-BRIDGE
PWT CABLE SHOWN		(Symbol)		HMS-11.20 M
GI PIPES		(Symbol)		C-CULVERT
RCC PIPES		(Symbol)		TO-TLACK CROSS
OPC JORT PIT		(Symbol)		

DRAWING TITLE : OPC AS BUILT DRAWING
 DRAWING NO. : STL/PR212/002
 CLIENT : SOUTH EASTERN RAILWAY
 PROJECT CODE : PR212


SUPREME
 TELECOMMUNICATIONS LIMITED

DRAWN BY	CHKD BY	APPRD BY	DATE	SCALE	PROJECTION	SHEET NO.	REV.
						2 OF 4	0

SOUTH EASTERN RAILWAY, SAMBALPUR OFC ROUTE PLAN RAIPUR TO MANDIR HASAUD

RAIPUR

TITLAGARH

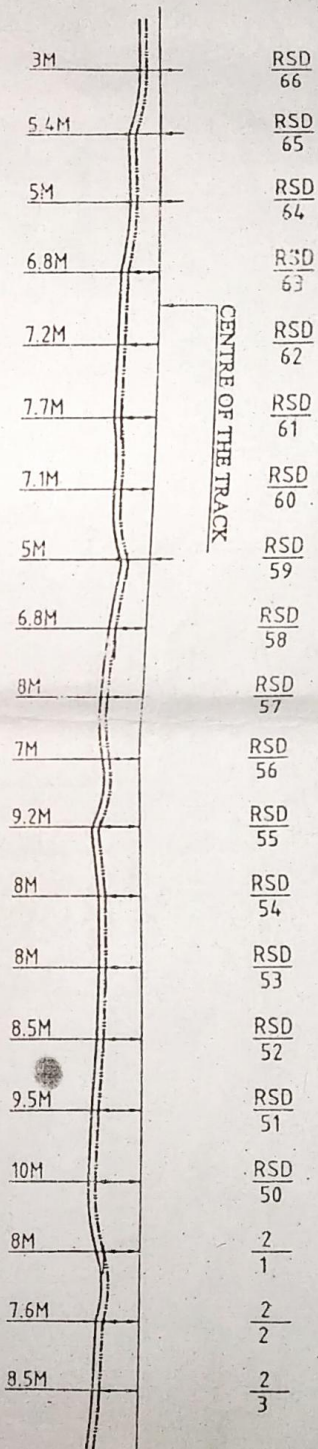

LEGEND

SYMBOL	DESCRIPTION	SYMBOL	DESCRIPTION	SYMBOL INDEX USED
---	OFC DUCT SHOWN	()	CULVERT	OS-ORDINARY SOIL
---	6 CORE SIG CABLE SHOWN	()	GRIDER BRIDGE	RS-ROCKY SOIL
---	PIPE CABLE SHOWN	()	LEVEL XING GATE	HM-HARD MS
---	GI PIPES	()		C-CULVERT
---	RCC PIPES	()		TC-TRACK CROSS
---	OFC JOINT PIT	()		



DRAWING TITLE : OFC AS BUILT DRAWING
DRAWING NO. : STL/PRJ212/ 003
CLIENT : SOUTH EASTERN RAILWAY
PROJECT CODE : PRJ212

		SUPREME TELECOMMUNICATIONS LIMITED													
DRAWN BY		CHECK BY		APPROD BY		DATE		SCALE		PROJECTION		SHEET		REV.	
[Signature]		[Signature]		[Signature]				NTS				3 OF 4		0	

SOUTH EASTERN RAILWAY, SAMBALPUR OFC ROUTE PLAN RAIPUR TO MANDIR HASAUD

RAIPUR


TITLAGARH

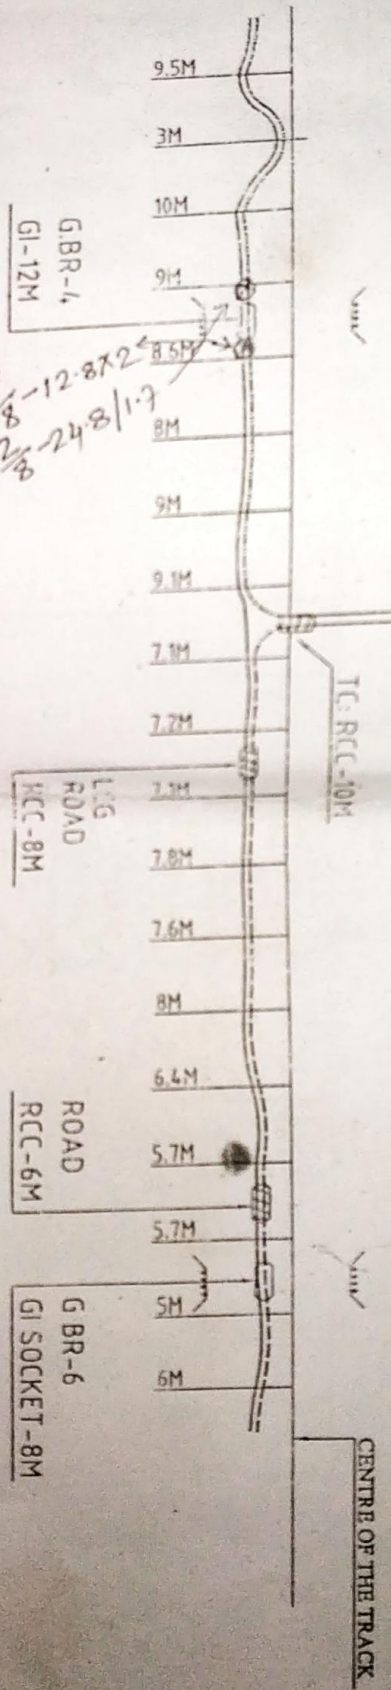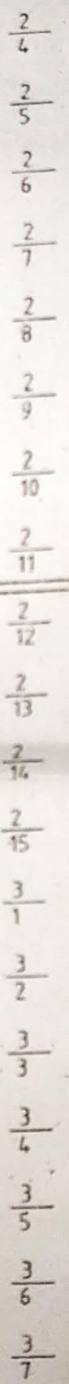

LEGEND

SYMBOL	DESCRIPTION	SYMBOL	DESCRIPTION	SYMBOL	INDEX USED
	OFC DUCT SHOWN		CULVERT		OS - ORDINARY SOIL
	6 CORE SIG CABLE SHOWN		BRIDGE		HMS - HARD MS C-CULVERT
	POWER CABLE		GIRDER BRIDGE		TC - TRACK CROSS
	PUF CABLE SHOWN		LEVEL XING GATE		
	GI PIPES				
	RCC PIPES				
	OFC JOINT PIT				

DRAWING TITLE : OFC AS BUILT DRAWING
 DRAWING NO. : STL/PRJ212/004
 CLIENT : SOUTH EASTERN RAILWAY
 PROJECT CODE : PRJ212

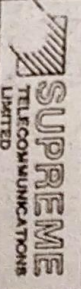


DRAWN BY: [Signature]
 CHECKED BY: [Signature]
 APPROVED BY: [Signature]
 DATE: [Blank]
 SCALE: [Blank]
 PROJECTION: [Blank]
 SHEET NO.: 4 OF 4

SOUTH EASTERN RAILWAY, SAMBALPUR
OFC ROUTE PLAN
RAIPUR TO MANDIR HASAUD

RAIPUR

TITLAGARH

3	8
3	9
3	10
3	11
3	12
3	13
3	14
3	15
4	1
4	2
4	3
4	4
4	5
4	6
4	7
4	8
4	9
4	10
4	11

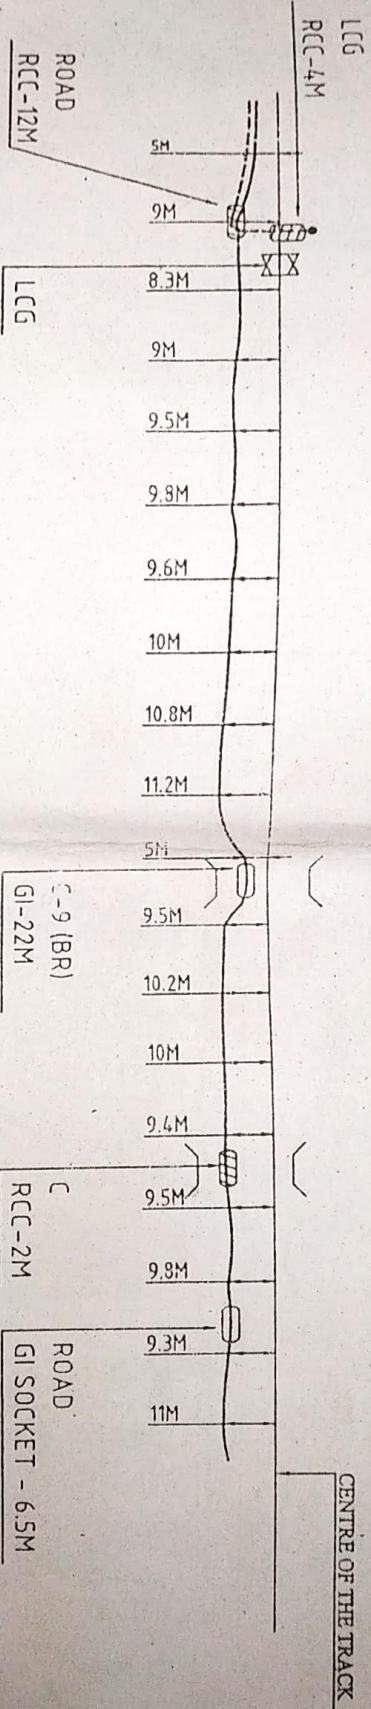

LEGEND

SYMBOL	DESCRIPTION	SYMBOL	DESCRIPTION	SYMBOL	INDEX USED
---	OFC/DUCT SHOWN	---	CULVERT	---	OS- ORDINARY SOIL
----	6 CORE SIG CABLE SHOWN	----	GIRDER BRIDGE	----	RS- ROCKY SOIL
----	POWER CABLE	----	LEVEL XING GATE	----	BR- BRIDGE
----	PVE CABLE SHOWN	----		----	HMS- HARD MS
----	GI PIPES	----		----	C- CULVERT
----	RCC PIPES	----		----	TC- TRACK CROSS
----	OFC JOINT PIT	----		----	

DRAWING TITLE : OFC AS BUILT DRAWING
DRAWING NO. : STL/PRJ212/ 006
CLIENT : SOUTH EASTERN RAILWAY
PROJECT CODE : PRJ212



DRWN BY	CHKD BY	APPRD BY	DATE	SCALE	PROJECTION	SHEET NO.	REV.
						5	0

SOUTH EASTERN RAILWAY, SAMBALPUR
OFC ROUTE PLAN
RAIPUR TO MANDIR HASAUD

RAIPUR

TITLAGARH

4	12
4	13
4	14
4	15
5	1
5	2
5	3
5	4
5	5
5	6
5	7
5	8
5	9
5	10
5	11
5	12
5	13
5	14
5	15

7.7M
8M
7.8M
7.5M
7.5M
6M
5.6M
7M
6.6M
7.6M
7.8M
9M
8.3M
9.7M
8M
6M
9M
6.7M
6.8M

CENTRE OF THE TRACK

G BR(12)
GI-19.6M
ROAD
GI-4.5M

LEGEND


SYMBOL	DESCRIPTION	SYMBOL	DESCRIPTION	SYMBOL INDEX USED
	OFC/DUCT SHOWN		CULVERT	OS-ORDINARY SOIL
	6 CORE SIG CABLE SHOWN		BR-BRIDGE	RS-ROCKY SOIL
	POWER CABLE		GIRDER BRIDGE	HM-HEAVY MS
	PUF CABLE SHOWN		C-CULVERT	TC-TRACK CROSS
	GI PIPES		LEVEL XING GATE	
	RCC PIPES			
	OFC JOINT PIT			

DRAWING TITLE : OFC AS BUILT DRAWING									
DRAWING NO. : STL/PR212/006									
CLIENT : SOUTH EASTERN RAILWAY									
PROJECT CODE : PR212									
SUPREME TELECOMMUNICATIONS LIMITED DRAWN BY: <i>[Signature]</i> CHECKED BY: <i>[Signature]</i> APPROVED BY: <i>[Signature]</i> DATE: <i>[Date]</i> SCALE: <i>[Scale]</i> PROJECTION: <i>[Projection]</i> SHEET NO.: <i>[Sheet No.]</i> TOTAL SHEETS: <i>[Total Sheets]</i>									

SOUTH EASTERN RAILWAY, SAMBALPUR OFC ROUTE PLAN RAIPUR TO MANDIR HASAUD

RAIPUR

TITLAGARH

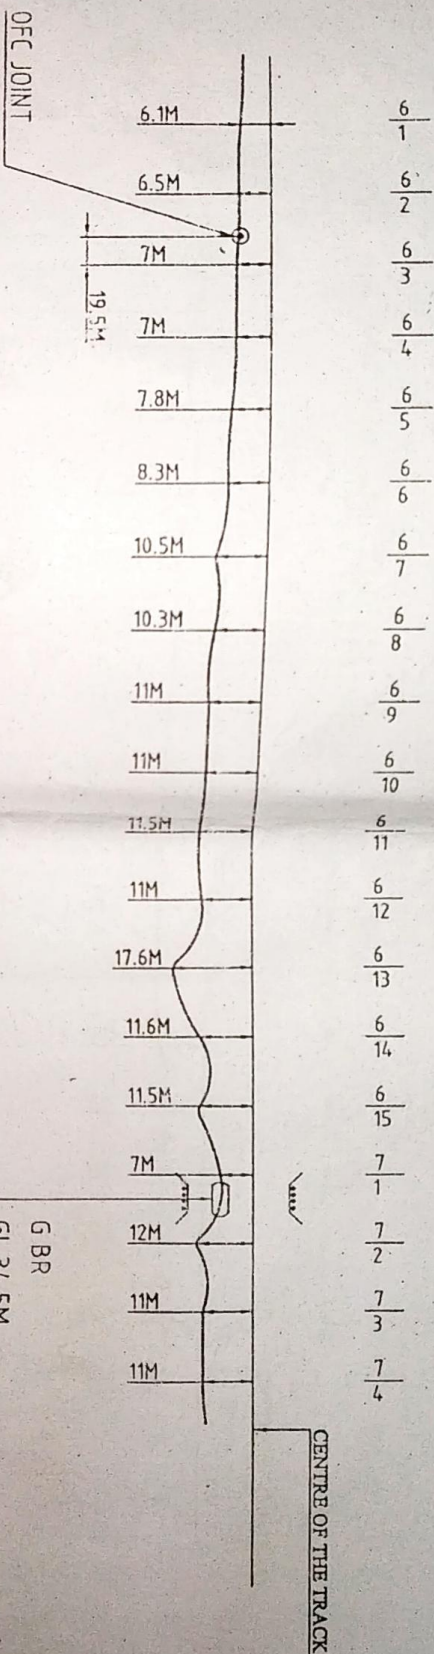

LEGEND

SYMBOL	DESCRIPTION	SYMBOL	DESCRIPTION	SYMBOL	DESCRIPTION
	OFC DUCT SHOWN		CUT VERT		OS-ORDINARY 2 SOIL
	6 CORE SIG CABLE SHOWN		BR-BRIDGE		HMS-HARD MS
	POWER CABLE		GIRDER BRIDGE		C-CUT VERT
	PUF CABLE SHOWN		LEVEL XING GATE		TC-TRACK CROSS
	GI PIPES				
	RCC PIPES				
	OFC JOINT PIT				

DRAWING TITLE : OFC AS BUILT DRAWING	
DRAWING NO. : STL/PRJ212/ 007	
CLIENT : SOUTH EASTERN RAILWAY	
PROJECT CODE : PRJ212	
DRAWN BY	CHECKED BY
APPROVED BY	DATE
SCALE	PROJECTION
SHEET NO.	SHEET REV.

SUPREME
TELECOMMUNICATIONS
LIMITED

DRAWN BY	CHECKED BY	APPROVED BY	DATE	SCALE	PROJECTION	SHEET NO.	SHEET REV.
						7	0714

RAIPUR

TITLAGARHI



DRAWING TITLE :	OFC AS BUILT DRAWING
DRAWING NO. :	STL/PRJ212/ 008
CLIENT :	SOUTH EASTERN RAILWAY
PROJECT CODE :	PRJ212

25/7/08 8.5M


abc. Moloyzen Survey PRJ212

SOUTH EASTERN RAILWAY, SAMBALPUR OFC ROUTE PLAN RAIPUR TO MANDIR HASAUD

RAIPUR

TITLAGARH

8/9 8/10 8/11 8/12 8/13 8/14 8/15 9/1 9/2 9/3 9/4 9/5 9/6 9/7 9/8 9/9 9/10 9/11 9/12

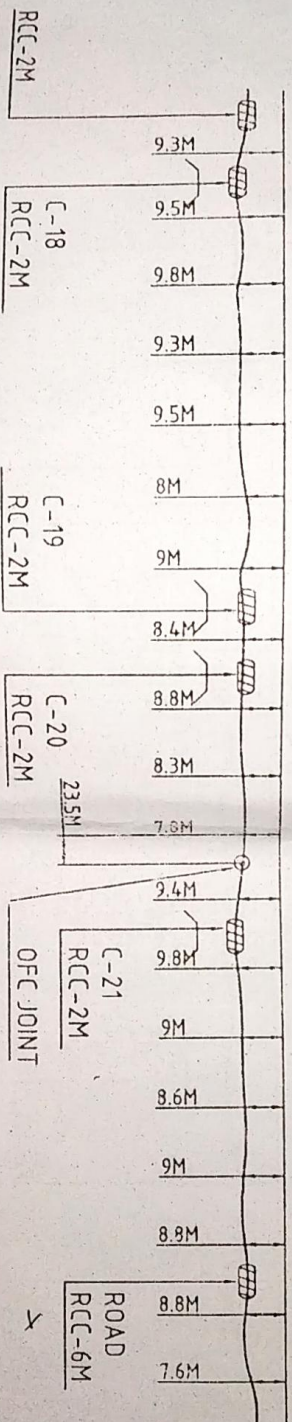

CENTRE OF THE TRACK

LEGEND

SYMBOL	DESCRIPTION	SYMBOL	DESCRIPTION	SYMBOL INDEX USED
---	OFC DUCT SHOWN	---	CULVERT	OS-ORDINARY SOIL
---	6 CORE SIG CABLE SHOWN	---	GIRDER BRIDGE	BR-BRIDGE
---	POWER CABLE	---	LEVEL XING GATE	HMS-HARDMS
---	PIPE CABLE SHOWN	---		G-CULVERT
---	GI PIPES	---		TC-TRACK CROSS
---	RCC PIPES	---		
---	OFC JOINT PIT	---		

DRAWING TITLE : OFC AS BUILT DRAWING
DRAWING NO. : STL/PRJ212/009
CLIENT : SOUTH EASTERN RAILWAY
PROJECT CODE : PRJ212


SUPREME
TELECOMMUNICATIONS
LIMITED

DRAWN BY	CHECKED BY	APPROVED BY	DATE	SCALE	PROJECTION	SHEET NO.	REV.

SOUTH EASTERN RAILWAY, SAMBALPUR OFC ROUTE PLAN RAIPUR TO MANDIR HASAUD

TITLAGARH

RAIPUR

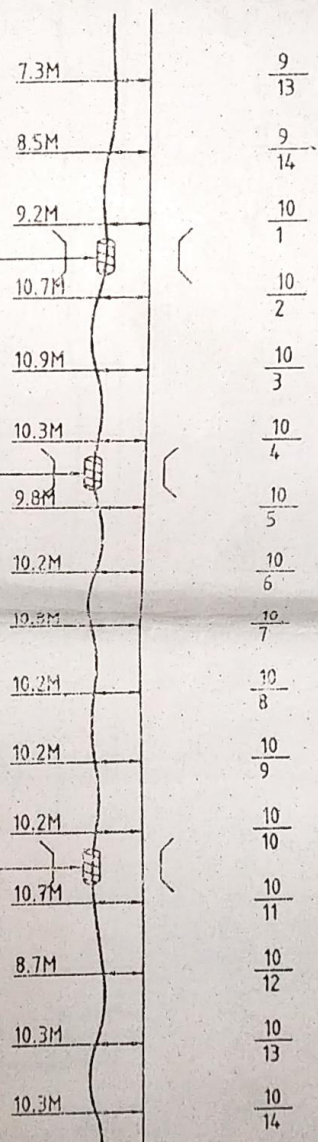

LEGEND

SYMBOL	DESCRIPTION	SYMBOL	DESCRIPTION	SYMBOL INDEX USED
—	OFC/ DUCT SHOWN	—	CULVERT	OS- ORDINARY SOIL
—	6 CORE SIG CABLE SHOWN	—	GIRDER BRIDGE	RS- ROCKY SOIL
—	POWER CABLE	—	LEVEL XING GATE	BR- BRIDGE
—	PIPE CABLE SHOWN	—		HS- HARD AS
—	GI PIPES	—		C- CULVERT
—	RCC PIPES	—		TC- TRACK CROSS
—	OFC JOINT PIT	—		

DRAWING TITLE : OFC AS BUILT DRAWING
DRAWING NO. : ST/PRJ212/ 010
CLIENT : SOUTH EASTERN RAILWAY
PROJECT CODE : PRJ212


SUPREME
TELECOMMUNICATIONS
LIMITED

DRWN BY	CHD BY	APPD BY	DATE	SCALE	PROJECTION	SHEET NO.	REV.
—	—	—	—	—	—	—	—

SOUTH EASTERN RAILWAY, SAMBALPUR OFC ROUTE PLAN RAIPUR TO MANDIR HASAUD

RAIPUR

TITLAGARH

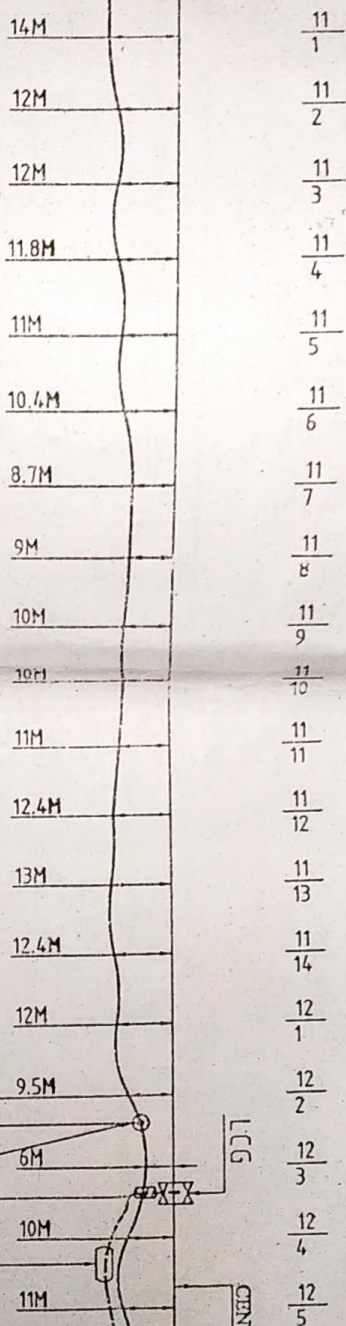

LEGEND

SYMBOL	DESCRIPTION	SYMBOL	DESCRIPTION	SYMBOL	DESCRIPTION
—	OFC/DUCT SHOWN	—	CULVERT	—	OS-ORDINARY SOIL
—	6 CORE SIG CABLE SHOWN	—	GIRDER BRIDGE	—	RS-ROCKY SOIL
—	POWER CABLE	—	LEVEL XING GATE	—	RR-BRIDGE
—	PIPE CABLE SHOWN	—		—	HMS-HARDMS
—	GI PIPES	—		—	C-CULVERT
—	RCC PIPES	—		—	TC-TRACK CROSS
—	OFC JOINT PIT	—		—	

DRAWING TITLE : OFC AS BUILT DRAWING
DRAWING NO. : STL/PRJ212 / 011
CLIENT : SOUTH EASTERN RAILWAY
PROJECT CODE : PRJ212


SUPREME
TELECOMMUNICATIONS
LIMITED

DATE	BY	CHKD	BY	APPRD	DATE	SCALE	PROJECTION	SHEET	REV.
11/11/2012	1	11/11/2012	1	11/11/2012	1	1:1	1	1	1

SOUTH EASTERN RAILWAY, SAMBALPUR
OFC ROUTE PLAN
RAIPUR TO MANDIR HASAUD

RAIPUR

TITLAGARH

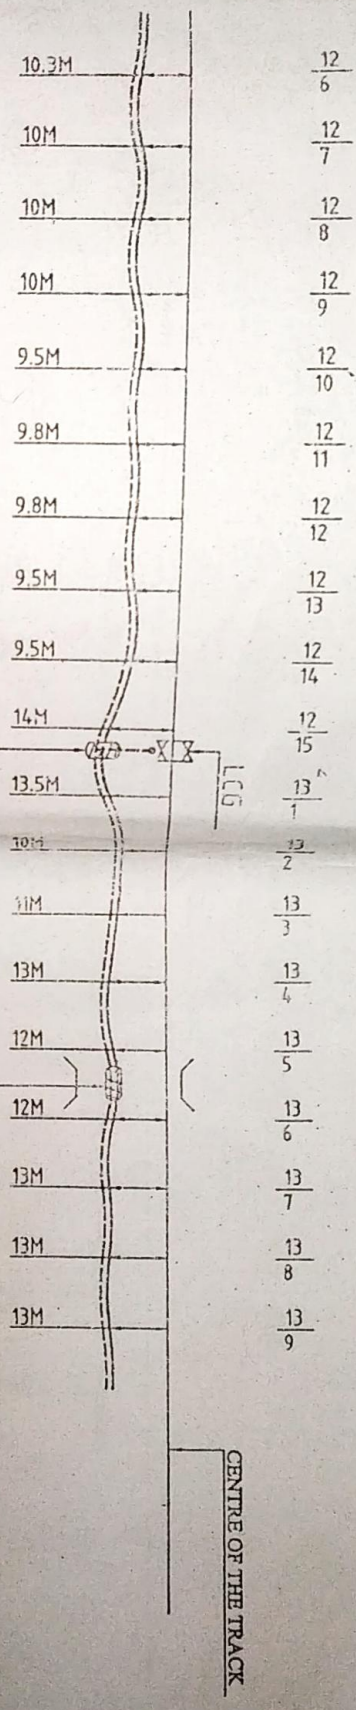

LEGEND

SYMBOL	DESCRIPTION	SYMBOL	DESCRIPTION
	OFC/DUCT SHOWN		CULVERT
	6 CORE SIG CABLE SHOWN		GIRDER BRIDGE
	POWER CABLE		LEVEL XING GATE
	PU? CABLE SHOWN		
	GI PIPES		
	RCC PIPES		
	OFC JOINT PIT		

DRAWING TITLE : OFC AS BUILT DRAWING
DRAWING NO. : STL/PR212/ 012
CLIENT : SOUTH EASTERN RAILWAY
PROJECT CODE : PR212

SUPREME
TELECOMMUNICATIONS LIMITED


DRAWN BY	CHECK BY	APPROVED BY	DATE	SCALE	PROJECTION	SHEET NO.

SOUTH EASTERN RAILWAY, SAMBALPUR OFC ROUTE PLAN RAIPUR TO MADIR HASAUD

RAIPUR

TITLAGARH

13/10 13/11 13/12 13/13 13/14 14/1 14/2 14/3 14/4 14/5 14/6 14/7 14/8 14/9 14/10 14/11 14/12 14/13 14/14 14/15

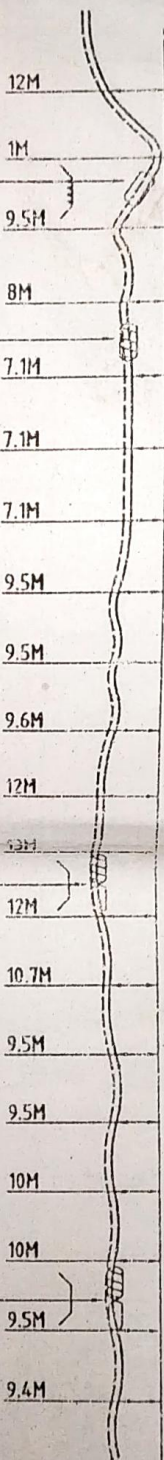

CENTRE OF THE TRACK

GBR
GI-18M
ROAD
GI-5M

C-35
GI-2.4M
RCC-6M

C-36
GI-2.4M
RCC-6M

LEGEND

SYMBOL	DESCRIPTION	SYMBOL	DESCRIPTION	SYMBOL	INDEX USED
---	OFC DUCT SHOWN	▽	CULVERT	OS	ORDINARY SOIL
---	6 CORE SIG CABLE SHOWN	▽	GIRDER BRIDGE	RS	ROCKY SOIL
---	POWER CABLE	▽	LEVEL XING GATE	BR	BRIDGE
---	P/F CABLE SHOWN	▽		HMS	HARD MS
○	GI PIPES	▽		C	CULVERT
○	RCC PIPES	▽		C	TRACK AND SS
○	OFC JOINT PIT	▽			

DRAWING TITLE : OFC AS BUILT DRAWING
DRAWING NO. : STL/PR212/ 013
CLIENT : SOUTH EASTERN RAILWAY
PROJECT CODE : PR212

SUPREME
TELECOMMUNICATIONS
LIMITED

DRAWN BY	CHECK BY	APPROVED BY	DATE	SCALE	PROJECTION	SHEET NO.	TOTAL SHEETS
						23	07/14



DWG NO.

DRG NO. 7

SOUTH EASTERN RAILWAY, SAMBALPUR
OFC ROUTE PLAN
RAIPUR TO MANDIR HASAUD

RAIPUR

TITLAGARH

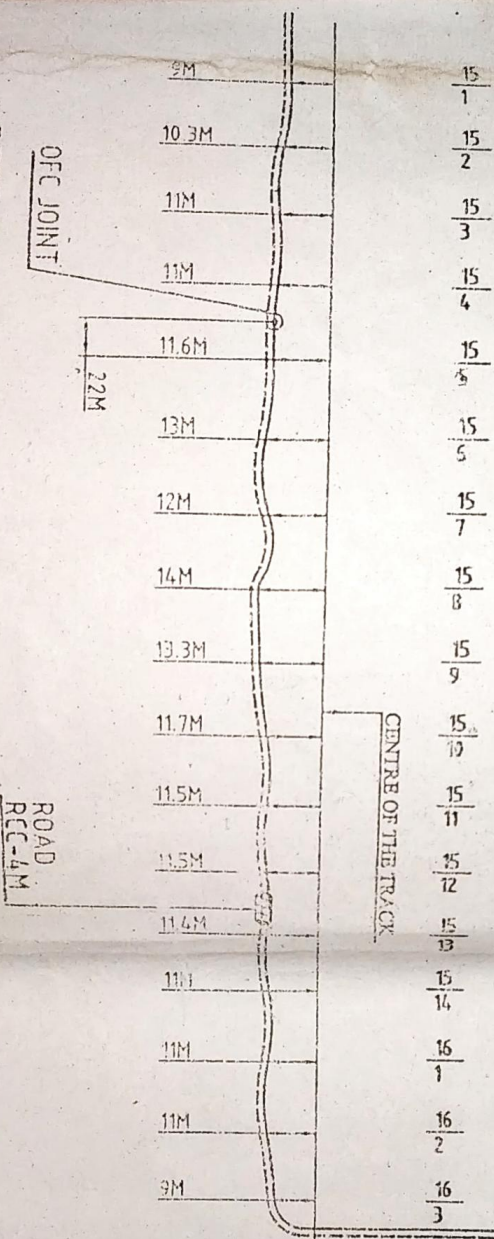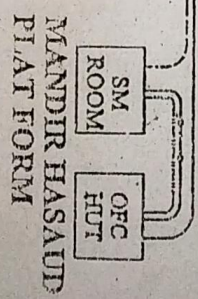

LEGEND

BOI	DESCRIPTION	SYMBOL	DESCRIPTION	SYMBOL INDEX USED
	OFC/DUCT SHOWN		CULVERT	OS. ORDINARY SOIL
	6 CORE SIG CABLE SHOWN		ORDER BRIDGE	PS. ROCKY SOIL
	POWER CABLE		ORDER BRIDGE	BR. BRIDGE
	PUR CABLE SHOWN		ORDER BRIDGE	TRANS. ROAD MS
	GI PIPES		ORDER BRIDGE	C. CULVERT
	RCC PIPES		ORDER BRIDGE	10- TRACK CROSS
	OFC JOINT PIT		ORDER BRIDGE	

DRAWING TITLE : OFC AS BUILT DRAWING
DRAWING NO. : ST/PRI212/014
CLIENT : SOUTH EASTERN RAILWAY
PROJECT CODE : PRI212

SUPREME
TELECOMS ENGINEERING
LIMITED

DATE	BY	CHKD	BY	APPRD	DATE	SCALE	PROJECTION	SHEET	NO.


BY: dra/telecoms/raipur, PRI212
DATE: 2
CHKD BY: 3
APPRD BY: 4
SCALE: 1:1000
PROJECTION: 1:1000
SHEET: 10
NO.: 8

ONE ROUTE PLAN

MANDUKIYAUD TO LAKHOLI

РАИПУР

III. AGARRH

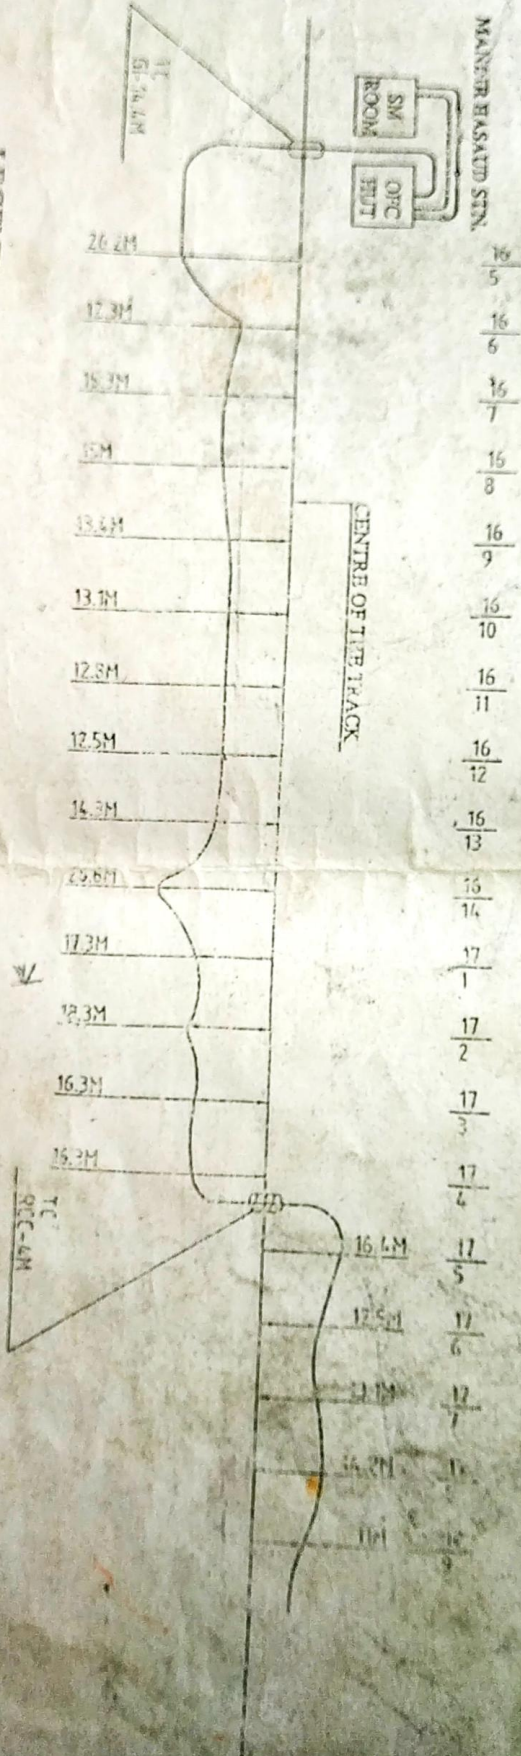

LEGEND

SYMBOL	DESCRIPTION	SYMBOL	DESCRIPTION	SYMBOL INDEX USED
	6 CORE SIG CABLE SHOWN		CULVERT	OS-ORDINARY SOIL
	PIPE C.M.P. SHOWN		GIRDER BRIDGE	SS-POCKET SOIL
	G PIPE		LEVEL XING GATE	BR-BRIDGE
	TCC PIPE			HMS-ROADWAY
	GRC JOINT			C-CULVERT
				TC-TRACK CROSS


NAME	NO.	DATE	TIME	PLACE
Mr. J. M. Anderson	1	1890	10:30	St. Paul

DRAWING TITLE : ONE AS BUILT DRAWING
DRAWING NO. : STL/PRJ/E/085
CLIENT : SOUTH EASTERN RAILWAY
PROJECT CODE : N-1916

SHEET NO.	
TOTAL SHEETS	
DATE OF ISSUE	
ISSUED BY	
CHECKED BY	
APPROVED BY	

RAIPUR

TITLAGARH

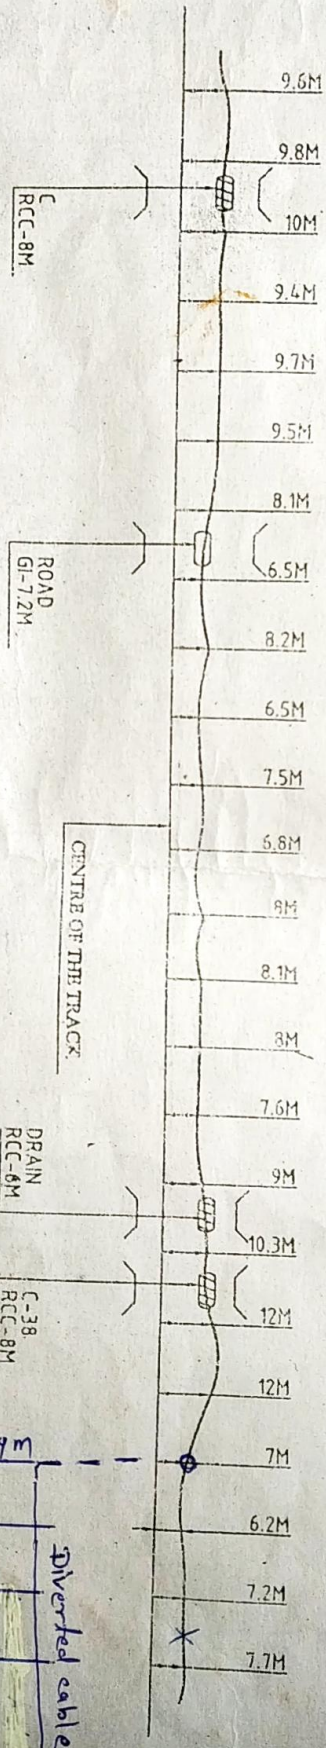


DRAWING TITLE :	OFC AS BUILT DRAWING
DRAWING NO. :	STL/PRJ212 / 016
CLIENT :	SOUTH EASTERN RAILWAY
PROJECT CODE :	PRJ212


37.9m

diverted cable

RAIPUR

TITLAGARH

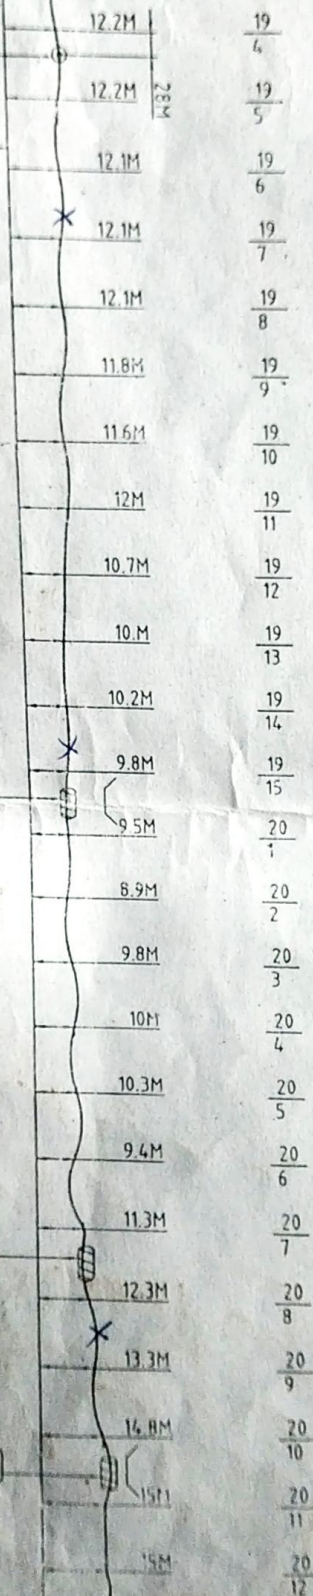[illegible]

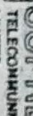
DRAWING TITLE : OFC AS BUILT DRAWING									
DRAWING NO. : STL/PRJ212/ 017									
CLIENT : SOUTH EASTERN RAILWAY									
PROJECT CODE : PRJ212									
SHEET									
522									
 SUPREME TELECOMMUNICATIONS LIMITED									
DRAWN BY	CHECK BY	APPROV BY	DATE	SCALE	PROJECTION	SHEET	NO.		
2	2					2	OF	6	0

SOUTH EASTERN RAILWAY, SAMBALPUR OFC ROUTE PLAN MANDIR HASAUD TO LAKHOLI

RAIPUR

TITLAGARH

20	13
20	14
20	15
21	1
21	2
21	3
21	4
21	5
21	6
21	7
21	8
21	9
21	10
21	11
21	12
21	13
21	14
21	15
22	1
22	2
22	3
22	4
22	5

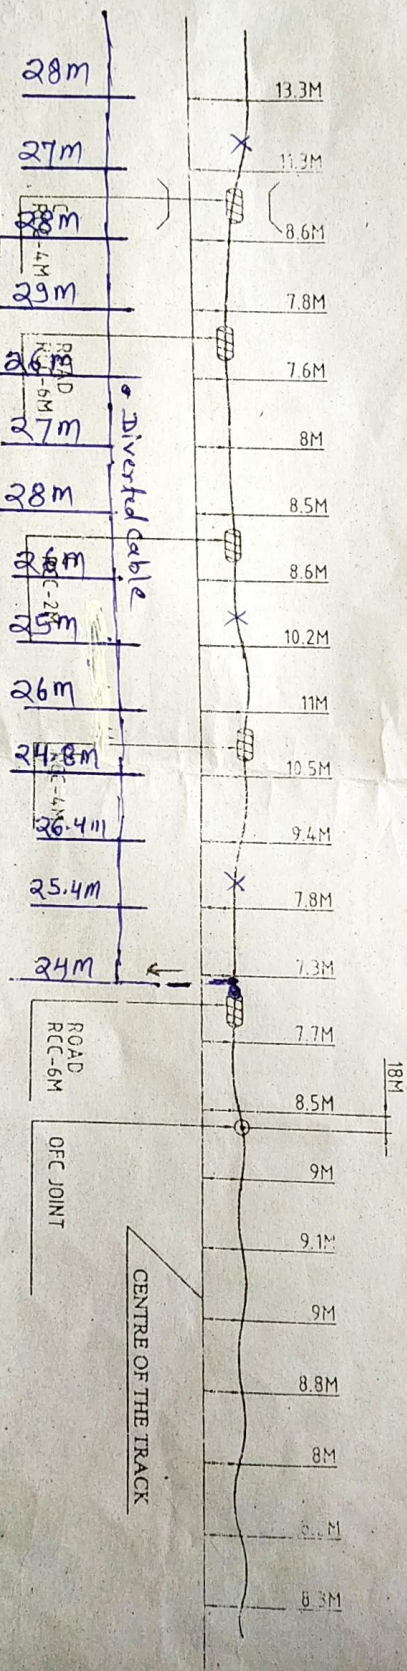

LEGEND

SYMBOL	DESCRIPTION	SYMBOL	DESCRIPTION	SYMBOL INDEX USED
	OFC DUCT SHOWN		CULVERT	OS - ORDINARY SOIL
	6 CORE SIG CABLE SHOWN		GIRDER BRIDGE	RS - ROCKY SOIL
	POWER CABLE		HMS-HARD MS C-CULVERT	
	PUF CABLE SHOWN		LEVEL XING GATE	FC - TRACK CROSS
	GI PIPES			
	RCC PIPES			
	OFC JOINT PII			

DRAWING TITLE : OFC AS BUILT DRAWING
 DRAWING NO. : STL/PRJ212/ 016
 CLIENT : SOUTH EASTERN RAILWAY
 PROJECT CODE : PRJ212


REV NO. 2
 DATE 3
 CHKD BY
 APPVD BY
 ZONE MGR
 CHANGE RPT
 SUPREME TELECOMMUNICATIONS LIMITED
 DRAWN BY
 CHKD BY
 APPVD BY
 DATE
 SCALE
 PROJECTION
 SHEET NO. 4 OF 8
 0

SOUTH EASTERN RAILWAY, SAMBALPUR OFC ROUTE PLAN MANDIR HASAUD TO LAKHOLI

RAIPUR

TITLAGARH

22	6
22	7
22	8
22	9
22	10
22	11
22	12
22	13
22	14
22	15
23	1
23	2
23	3
23	4
23	5
23	6
23	7
23	8
23	9
23	10
23	11
23	12

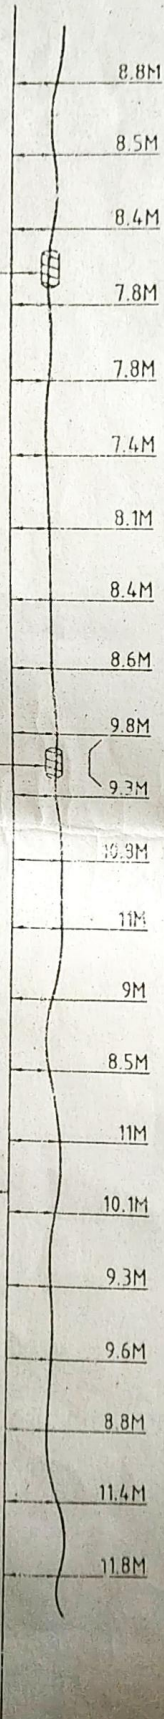

ROAD
RCC-4M

C-43
RCC-6M

CENTRE OF THE TRACK

LEGEND

SYMBOL	DESCRIPTION	SYMBOL	DESCRIPTION	SYMBOL INDEX USED
[Symbol]	OFC/ DUCT SHOWN	[Symbol]	CULVERT	OS- ORDINARY SOIL
[Symbol]	6 CORE SIG CABLE SHOWN	[Symbol]	GIRDER BRIDGE	RS- ROCKY SOIL
[Symbol]	POWER CABLE	[Symbol]	LEVEL XING GATE	BR- BRIDGE
[Symbol]	PWF CABLE SHOWN			HMS- HARD MS
[Symbol]	GI PIPES			C- CULVERT
[Symbol]	RCC PIPES			TC- TRACK CROSS
[Symbol]	OFC JOINT PTT			

REV NO	REV NO	DATE	CHNG BY	APPR BY	CHKZ	CHANCE	REV
1	2	3					

DRAWING TITLE : OFC AS BUILT DRAWING
 DRAWING NO. : STL/PR212/ 019
 CLIENT : SOUTH EASTERN RAILWAY
 PROJECT CODE : PR212

SUPREME
TELECOMMUNICATIONS LIMITED

DRWN BY	CHNG BY	APPR BY	DATE	SCALE	PROJECTION	SHEET
						5 OF 8


SOUTH EASTERN RAILWAY, SAMBALPUR
OFC ROUTE PLAN
MANDIR TASAUD TO LAKHOLI

RAIPUR

TITLAGARH

23	13
23	14
24	1
24	2
24	3
24	4
24	5
24	6
24	7
24	8
24	9
24	10
24	11
24	12
24	13
24	14
24	15
25	1
25	2
25	3
25	4
25	5

25 (+92), 25
25 (-9) 25

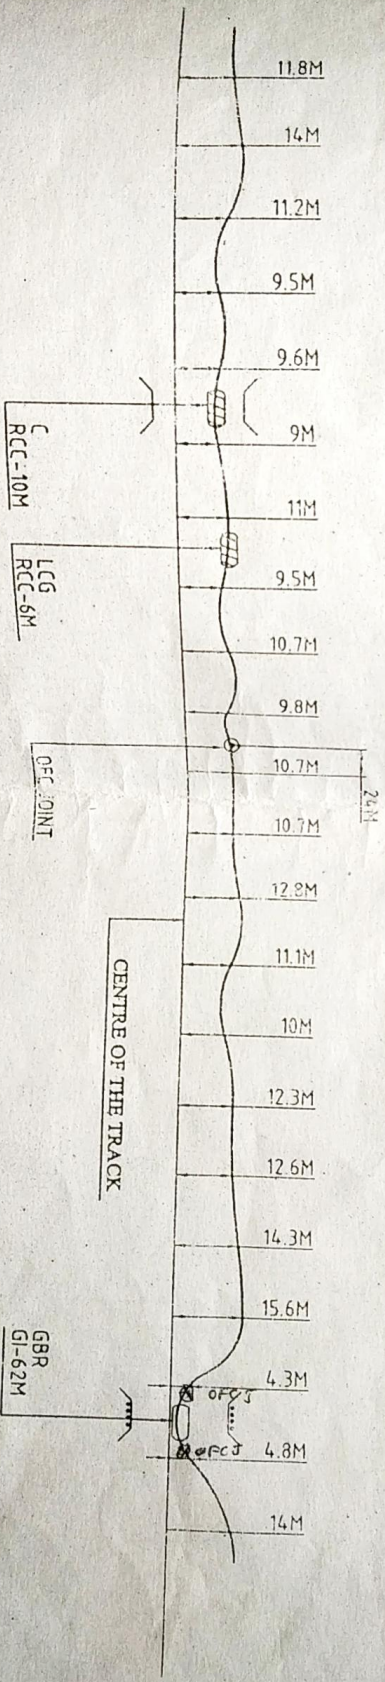

LEGEND

SYMBOL	DESCRIPTION	SYMBOL	DESCRIPTION	SYMBOL INDEX USED
—	OFC/ DUCT SHOWN	—	CUL VERT	OS-ORDINARY SOIL
—	6 CORE SIG CABLE SHOWN	—	GIRDER BRIDGE	RS-ROCK & SOIL
—	POWER CABLE	—	LEVEL XING GATE	HMS-HARD MS
—	PIT CABLE SHOWN	—		C-CULVERT
—	GI PIPES	—		TC-TRACK CROSS
—	RCC PIPES	—		
—	OFC JOINT PIT	—		

DRAWING TITLE : OFC AS BUILT DRAWING
DRAWING NO. : STL/PRJ212 / 020
CLIENT : SOUTH EASTERN RAILWAY
PROJECT CODE : PRJ212

SUPREME TELECOMMUNICATIONS LIMITED	DRWN BY	CHKD BY	APPRD BY	DATE	SCALE	PROJECTION	SHEET	REV.


DRG NO: 7

SOUTH EASTERN RAILWAY, SAMBALPUR
OFC ROUTE PLAN
MANDIR HASAUD TO LAKHOLI

RAIPUR

TITLAGARH


25	6	25	7	25	8	25	9	25	10	25	11	25	12	25	13	25	14	26	1	26	2	26	3	26	4	26	5	26	6	26	7	26	8	26	9	26	10	26	11	26	12	26	13	26	14	26	15	27	1	27	2	27	3
----	---	----	---	----	---	----	---	----	----	----	----	----	----	----	----	----	----	----	---	----	---	----	---	----	---	----	---	----	---	----	---	----	---	----	---	----	----	----	----	----	----	----	----	----	----	----	----	----	---	----	---	----	---

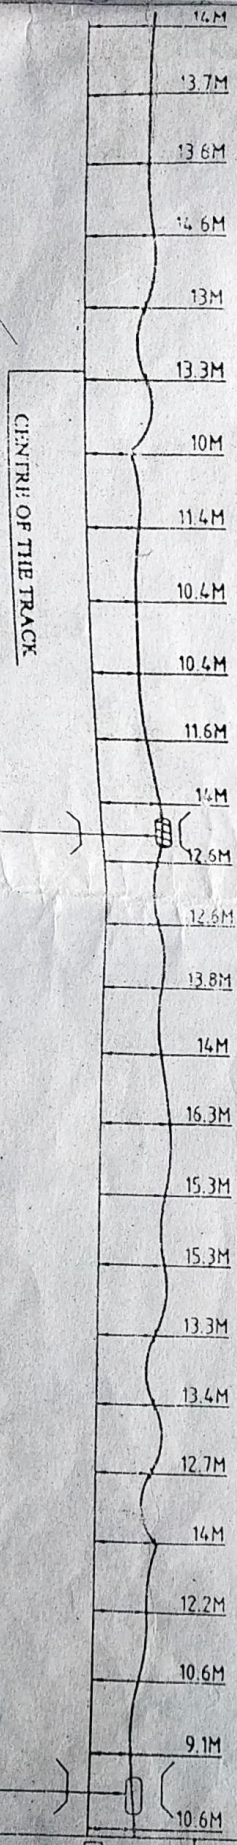

LEGEND

SYMBOL	DESCRIPTION	SYMBOL	DESCRIPTION	SYMBOL INDEX USED
---	OFC DUCT SHOWN	---	CULVERT	OS-ORDINARY SOIL
---	6 CORE SIG CABLE SHOWN	---	GIRDER BRIDGE	RS-ROCK & SOIL
---	POWER CABLE	---	LEVEL XING GATE	HMS-HARD MS
---	PIPE CABLE SHOWN	---		C-CULVERT
---	GI PIPES	---		TC-TRACK CROSS
---	RCC PIPES	---		
---	OFC JOINT PIT	---		

DRAWING TITLE : OFC AS BUILT DRAWING
DRAWING NO. : STL/PR212/021
CLIENT : SOUTH EASTERN RAILWAY
PROJECT CODE : PR212

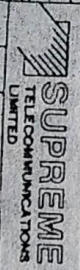


DATE	CHKD BY	APPRD BY	DATE	SCALE	PROJECTION	SHEET
3						7 OF 8

DRG NO.

SOUTH EASTERN RAILWAY, SAMBALPUR
OFC ROUTE PLAN
MANDIR HASAUD TO LAKHOLI

RAIPUR

TITLAGARH

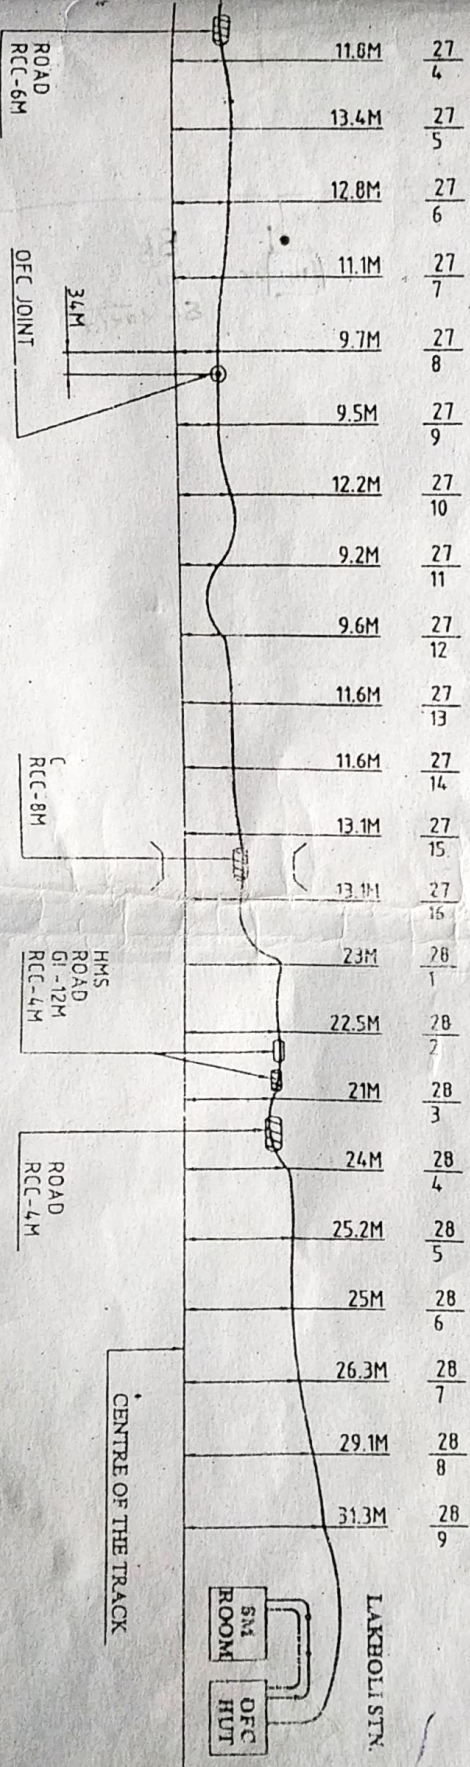

LEGEND

SYMBOL	DESCRIPTION	SYMBOL	DESCRIPTION	SYMBOL INDEX USED
—	OFC/DUCT SHOWN	—	CULVERT	OS-ORDINARY SOIL
—	6 CORE SIG CABLE SHOWN	—	GIRDER BRIDGE	RR-BRIDGE
—	POWER CABLE	—	LEVEL XING GATE	HMS-HARD MS
—	PUP CABLE SHOWN	—		C-CULVERT
—	GI PIPES	—		TC-TRACK CROSS
—	RCC PIPES	—		
—	OFC JOINT PIT	—		

DATE	CHKD BY	APPD BY	DATE	SCALE	PRODUCTION	SHEET
DRAWING TITLE : OFC AS BUILT DRAWING						
DRAWING NO. : STL/PRJ212/022						
CLIENT : SOUTH EASTERN RAILWAY						
PROJECT CODE : PRJ212						
SUPREME TELECOMMUNICATIONS LIMITED						
DRWN BY	CHKD BY	APPD BY	DATE	SCALE	PRODUCTION	SHEET
8 OF 8						